


FIRST FLOOR EGRESS PLAN
1"=20'-0"

ADDITIONS AND RENOVATIONS
LEDYARD HIGH SCHOOL CRITICAL NEEDS
 24 GALLUP HILL ROAD
 LEDYARD, CT

EGRESS PLAN
 FIRST FLOOR
 PROJECT #072-0066
 PHASE 2 OF 3

CONSULTANTS:
 LANDSCAPE ARCHITECTS:
M•R•ROMING ASSOCIATES P.C.
 Landscape Architects • Land Planners
 West Hartford Connecticut
 STRUCTURAL ENGINEERS:
GIRARD AND COMPANY, LLP
 STRUCTURAL ENGINEERS
 40 WETHERFIELD AVENUE
 HARTFORD CONNECTICUT
 P. (860) 524-5196 F. (860) 548-1463
 WWW.GIRARDCO.COM

MECHANICAL/ELECTRICAL/PLUMBING ENGINEERS:
QUINLAN, GIANNONI & LIVINGSTON, INC.
 CONSULTING ENGINEERS
 2074 PARK STREET
 HARTFORD, CT 06108
 TEL (860) 238-4288
 FAX (860) 232-9841

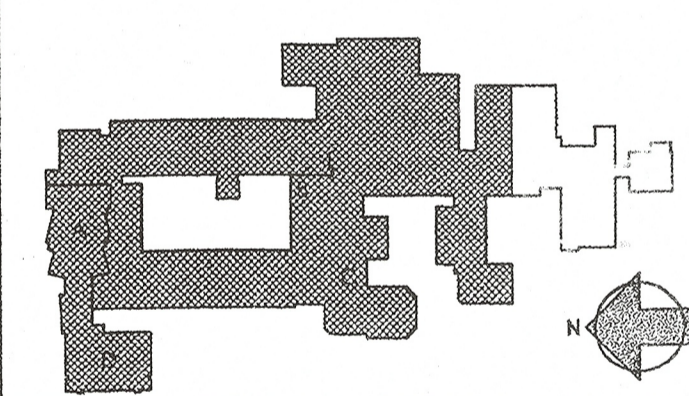

THIS DRAWING AND ITS CONTENTS ARE THE PROPERTY OF THE ARCHITECT AND MAY NOT BE REPRODUCED OR USED IN ANY WAY OTHER THAN THAT WHICH WAS ORIGINALLY INTENDED WITHOUT THE ARCHITECT'S CONSENT.

DO NOT SCALE THE DRAWING. USE THE DIMENSIONS GIVEN. IF THERE ARE ANY DISCREPANCIES OR QUESTIONS, CONTACT THE ARCHITECT.

REVISIONS:
 BID DATE: NOV. 1, 2002
 DATE: JULY 25, 2002
 SCALE: 1"=20'-0"

akPark Architects LLC
 312 Park Rd. W. Hartford, CT (860)232-6664

- ▶ EXISTING
- ▶ ADD
- M-Monitor
- Existing Rack
- New Location For Rack

AS BUILT

G-3